

# Work Order ID 91933

\*91933\*

Page 1

October-19-12 2:34:30 PM

Item ID: D350-689-023

Accept

\*N900040100\*

Setup Start

\*NS1\*

Revision ID:

Stop

\*NS2\*

Item Name: Energy Attenuating Floor Provisions

Start Date: 10/22/12 Start Qty: 1.00

\*1\*

Cust Item ID:

Required Date: 11/09/12 Req'd Qty: 1.00

\*1\*

Customer:

Reference:

Approvals: Process Plan: MLS

Date: 12-10-22 Tooling:

Date:

Run Start

\*NR1\*

QC:

Date: SPC (Y/N):

Date:

Stop

\*NR2\*

Sequence ID/ Work Center ID	Operation Description	Set Up/ Run Hours	Tool ID	Tool #	Plan Code	Accept Qty	Reject Qty	Reject Number	Insp. Stamp
Draw Nbr	Revision Nbr								
DSI 9588	A								
IIN-D350-689	B								
100	DOCUMENT CONTROL	0.00							
*100*									
DC	Memo	0.00							
Document Control	Photocopy bluefile and create labels per PPP D350-689-023 CHG004								
110	Pick Kit	0.00							
*110*									
Packaging	Memo	0.00							
Packaging									

DAS  
15  
12/10/09

*J. de la MLS 12-10-25*

*[Signature]*

*12/10/24 JB*

NCR: Yes / No

**WORK ORDER NON-CONFORMANCE / UPDATE**

DQA: \_\_\_\_\_ Date: \_\_\_\_\_

QA Closed: \_\_\_\_\_ Date: \_\_\_\_\_

Work Order: _____  Part No. _____  NCR No. _____				<b>DISPOSITION</b>  Rework <input type="checkbox"/> Scrap <input type="checkbox"/> Use-as-is <input type="checkbox"/> Work Order Update <input type="checkbox"/>		<b>AGAINST DEPARTMENT/PROCESS</b>  <table style="width:100%; border: none;"> <tr> <td style="width:25%;">Skid-tube <input type="checkbox"/></td> <td style="width:25%;">Crosstube <input type="checkbox"/></td> <td style="width:25%;">Water Jet <input type="checkbox"/></td> <td style="width:25%;">Engineering <input type="checkbox"/></td> </tr> <tr> <td>Machining <input type="checkbox"/></td> <td>Small Fab <input type="checkbox"/></td> <td>Prod. Eng. Coord. <input type="checkbox"/></td> <td>Quality <input type="checkbox"/></td> </tr> <tr> <td>Thermoforming <input type="checkbox"/></td> <td>Finishing <input type="checkbox"/></td> <td>Rec/Store/Packaging <input type="checkbox"/></td> <td>Other <input type="checkbox"/></td> </tr> <tr> <td>Large Fab <input type="checkbox"/></td> <td>Composite <input type="checkbox"/></td> <td>Supplier <input type="checkbox"/></td> <td></td> </tr> </table>						Skid-tube <input type="checkbox"/>	Crosstube <input type="checkbox"/>	Water Jet <input type="checkbox"/>	Engineering <input type="checkbox"/>	Machining <input type="checkbox"/>	Small Fab <input type="checkbox"/>	Prod. Eng. Coord. <input type="checkbox"/>	Quality <input type="checkbox"/>	Thermoforming <input type="checkbox"/>	Finishing <input type="checkbox"/>	Rec/Store/Packaging <input type="checkbox"/>	Other <input type="checkbox"/>	Large Fab <input type="checkbox"/>	Composite <input type="checkbox"/>	Supplier <input type="checkbox"/>	
Skid-tube <input type="checkbox"/>	Crosstube <input type="checkbox"/>	Water Jet <input type="checkbox"/>	Engineering <input type="checkbox"/>																								
Machining <input type="checkbox"/>	Small Fab <input type="checkbox"/>	Prod. Eng. Coord. <input type="checkbox"/>	Quality <input type="checkbox"/>																								
Thermoforming <input type="checkbox"/>	Finishing <input type="checkbox"/>	Rec/Store/Packaging <input type="checkbox"/>	Other <input type="checkbox"/>																								
Large Fab <input type="checkbox"/>	Composite <input type="checkbox"/>	Supplier <input type="checkbox"/>																									
<b>Root Cause</b>	<b>Date</b>	<b>Step</b>	<b>Qty</b>	<b>Description of work order update or Non-conformance</b>	<b>Initial Chief Eng</b>	<b>Action Description</b>	<b>Sign &amp; Date</b>	<b>Verification</b>	<b>QC Inspector</b>																		
Doc/Data <input type="checkbox"/>																											
Equip/Tooling <input type="checkbox"/>																											
Operator <input type="checkbox"/>																											
Material <input type="checkbox"/>																											
Setup <input type="checkbox"/>																											
Other <input type="checkbox"/>																											
Process <input type="checkbox"/>																											
Supplier <input type="checkbox"/>																											
Training <input type="checkbox"/>																											
Unapproved <input type="checkbox"/>																											
<b>FAULT CATEGORY</b>																											
<b>Landing Gear</b> <input type="checkbox"/> Bending <input type="checkbox"/> Centre Not Concentric to O/S <input type="checkbox"/> Cracks <input type="checkbox"/> Crushed/Crimped <input type="checkbox"/> Cuffs <input type="checkbox"/> Heat Treat <input type="checkbox"/> Inspection Strip in Tube <input type="checkbox"/> Ripples in Bend <input type="checkbox"/> Torque Waves in Extrusion <input type="checkbox"/> Turning Sequence <input type="checkbox"/> Wave/Twist in Tube			<b>General</b> <input type="checkbox"/> Bend <input type="checkbox"/> BOM/Route <input type="checkbox"/> Broken/Damaged <input type="checkbox"/> Burrs <input type="checkbox"/> Contamination <input type="checkbox"/> Countersink <input type="checkbox"/> Cut Too Short <input type="checkbox"/> Drill Holes <input type="checkbox"/> Drawing <input type="checkbox"/> Finish <input type="checkbox"/> Folio			<input type="checkbox"/> Grain <input type="checkbox"/> Hardware <input type="checkbox"/> Inspection Incomplete <input type="checkbox"/> Instructions Incomplete/Unclear <input type="checkbox"/> Maintenance <input type="checkbox"/> Mislabeled <input type="checkbox"/> Misread <input type="checkbox"/> Offset <input type="checkbox"/> Out of Calibration <input type="checkbox"/> Out of Sequence <input type="checkbox"/> Outside Dimensions			<input type="checkbox"/> Ovalized <input type="checkbox"/> Over/Under tolerance <input type="checkbox"/> Part Incorrect <input type="checkbox"/> Part Lost/Missing <input type="checkbox"/> Part Moved <input type="checkbox"/> Positioned Wrong <input type="checkbox"/> Power Loss/Surge  <input type="checkbox"/> Pressure/Forced <input type="checkbox"/> Temperature/Cure <input type="checkbox"/> Weld <input type="checkbox"/> Wrong Stock Pulled  <input type="checkbox"/> Other																		

**Work Order ID 91933****\*91933\***

Page 2

October-19-12 2:34:30 PM

Item ID: D350-689-023

Accept

**\*N900040100\***Setup Start **\*NS1\***

Revision ID:

Stop **\*NS2\***

Item Name: Energy Attenuating Floor Provisions

Start Date: 10/22/12 Start Qty: 1.00 **\*1\***

Cust Item ID:

Required Date: 11/09/12 Req'd Qty: 1.00 **\*1\***

Customer:

Reference:

Approvals: Process Plan: \_\_\_\_\_ Date: \_\_\_\_\_ Tooling: \_\_\_\_\_ Date: \_\_\_\_\_

Run Start **\*NR1\***

QC: \_\_\_\_\_ Date: \_\_\_\_\_ SPC (Y/N): \_\_\_\_\_ Date: \_\_\_\_\_

Stop **\*NR2\***

Sequence ID/ Work Center ID	Operation Description	Set Up/ Run Hours	Tool ID	Tool #	Plan Code	Accept Qty	Reject Qty	Reject Number	Insp. Stamp
--------------------------------	--------------------------	----------------------	---------	--------	--------------	---------------	---------------	------------------	----------------

120	QC4- 100% Inspect kits for completeness	0.00							
-----	---	------	--	--	--	--	--	--	--

**\*120\***

QC

Memo

Quality Control

DAS  
15  
2-89  
12/11/09

130		0.00							
-----	--	------	--	--	--	--	--	--	--

**\*130\***

Packaging

Packaging

Memo

Packaging

Identify and pack for shipping as per PPP D350-689-023

Location: \_\_\_\_\_  
PPP Rev: \_\_\_\_\_

140	QC21- Final Inspection - Work Order Release	0.00							
-----	---	------	--	--	--	--	--	--	--

**\*140\***

QC

Memo

Quality Control

12/11/13

mf  
12-11-12

NCR: Yes / No

## WORK ORDER NON-CONFORMANCE / UPDATE

DQA: \_\_\_\_\_ Date: \_\_\_\_\_

QA Closed: \_\_\_\_\_ Date: \_\_\_\_\_

Work Order: _____  Part No. _____  NCR No. _____	<b>DISPOSITION</b>  <div style="display: flex; justify-content: space-around;"> <div>Rework <input type="checkbox"/></div> <div>Skid-tube <input type="checkbox"/></div> <div>Crosstube <input type="checkbox"/></div> <div>Water Jet <input type="checkbox"/></div> <div>Engineering <input type="checkbox"/></div> </div> <div style="display: flex; justify-content: space-around;"> <div>Scrap <input type="checkbox"/></div> <div>Machining <input type="checkbox"/></div> <div>Small Fab <input type="checkbox"/></div> <div>Prod. Eng. Coord. <input type="checkbox"/></div> <div>Quality <input type="checkbox"/></div> </div> <div style="display: flex; justify-content: space-around;"> <div>Use-as-is <input type="checkbox"/></div> <div>Thermoforming <input type="checkbox"/></div> <div>Finishing <input type="checkbox"/></div> <div>Rec/Store/Packaging <input type="checkbox"/></div> <div>Other <input type="checkbox"/></div> </div> <div style="display: flex; justify-content: space-around;"> <div>Work Order Update <input type="checkbox"/></div> <div>Large Fab <input type="checkbox"/></div> <div>Composite <input type="checkbox"/></div> <div>Supplier <input type="checkbox"/></div> </div>	
--	---	--

Root Cause	Date	Step	Qty	Description of work order update or Non-conformance	Initial Chief Eng	Action Description	Sign & Date	Verification	QC Inspector
Doc/Data									
Equip/Tooling									
Operator									
Material									
Setup									
Other									
Process									
Supplier									
Training									
Unapproved									

### FAULT CATEGORY

<b>Landing Gear</b> <input type="checkbox"/> Bending <input type="checkbox"/> Centre Not Concentric to O/S <input type="checkbox"/> Cracks <input type="checkbox"/> Crushed/Crimped <input type="checkbox"/> Cuffs <input type="checkbox"/> Heat Treat <input type="checkbox"/> Inspection Strip in Tube <input type="checkbox"/> Ripples in Bend <input type="checkbox"/> Torque Waves in Extrusion <input type="checkbox"/> Turning Sequence <input type="checkbox"/> Wave/Twist in Tube	<b>General</b> <input type="checkbox"/> Bend <input type="checkbox"/> BOM/Route <input type="checkbox"/> Broken/Damaged <input type="checkbox"/> Burrs <input type="checkbox"/> Contamination <input type="checkbox"/> Countersink <input type="checkbox"/> Cut Too Short <input type="checkbox"/> Drill Holes <input type="checkbox"/> Drawing <input type="checkbox"/> Finish <input type="checkbox"/> Folio	<input type="checkbox"/> Grain <input type="checkbox"/> Hardware <input type="checkbox"/> Inspection Incomplete <input type="checkbox"/> Instructions Incomplete/Unclear <input type="checkbox"/> Maintenance <input type="checkbox"/> Mislabeled <input type="checkbox"/> Misread <input type="checkbox"/> Offset <input type="checkbox"/> Out of Calibration <input type="checkbox"/> Out of Sequence <input type="checkbox"/> Outside Dimensions	<input type="checkbox"/> Ovalized <input type="checkbox"/> Over/Under tolerance <input type="checkbox"/> Part Incorrect <input type="checkbox"/> Part Lost/Missing <input type="checkbox"/> Part Moved <input type="checkbox"/> Positioned Wrong <input type="checkbox"/> Power Loss/Surge  <input type="checkbox"/> Pressure/Forced <input type="checkbox"/> Temperature/Cure <input type="checkbox"/> Weld <input type="checkbox"/> Wrong Stock Pulled  <input type="checkbox"/> Other
---	---	---	---

# Picklist Print

October-19-12 2:34:29 PM

Page 1

Work Order ID: 91933

Parent Item: D350-689-023

Parent Item Name: Energy Attenuating Floor Provisions

Start Date: 10/22/12

Required Date: 11/09/12

Start Qty: 1.00

Required Qty: 1.00

Comments: IPP Rev:A 08-12-23 new issue DD verified by:EC IPP Rev:B revise route seq DD  
10.02.12 verified by:JLM IPP Rev:C chg003 DD 11.09.28 verified by:JLM  
IPP Rev:D 12.01.12 now @ CHG004 (ecn12-501) DD VERF:EC

Component Item ID/ Item Name	Replacement Item ID	Mfg/ Purch	Bin Item	Primary Location	Last Location	Route Seq ID	Unit of Measure	Qty on Hand	Qty per Kit	Total Qty	Qty Issued	Date Issued	Status
D4575-1 Beam		Manufactured	No			110	Each	0.0000	0	90773	✓ 20		✓
D4575-3 Doubler		Manufactured	No			110	Each	2.0000	0	92621	✓ 20		✓
				<u>Location</u>		<u>Loc Qty</u>		<u>Loc Code</u>					
				ST197		2							
				79969		2							
D3027-7 Clip		Manufactured	No			110	Each	25.0000	4	4	✓ 20		✓
				<u>Location</u>		<u>Loc Qty</u>		<u>Loc Code</u>					
				ST024		25							
				70582		2							
				86813		11				86813			
				88396		12							
D3811-041 Seat Track Assembly		Manufactured	No			110	Each	3.0000	0	87359	✓ 20		✓
				<u>Location</u>		<u>Loc Qty</u>		<u>Loc Code</u>					
				ST262		1							
				73447		1							
				ST263		2							
				87359		2							

NCR: Yes / No

**WORK ORDER NON-CONFORMANCE / UPDATE**

DQA: \_\_\_\_\_ Date: \_\_\_\_\_

QA Closed: \_\_\_\_\_ Date: \_\_\_\_\_

Work Order: _____  Part No. _____  NCR No. _____				<b>DISPOSITION</b>  Rework <input type="checkbox"/> Scrap <input type="checkbox"/> Use-as-is <input type="checkbox"/> Work Order Update <input type="checkbox"/>		<b>AGAINST DEPARTMENT/PROCESS</b>  <div style="display: flex; justify-content: space-between;"> <div>           Skid-tube <input type="checkbox"/>            Machining <input type="checkbox"/>            Thermoforming <input type="checkbox"/>            Large Fab <input type="checkbox"/> </div> <div>           Crosstube <input type="checkbox"/>            Small Fab <input type="checkbox"/>            Finishing <input type="checkbox"/>            Composite <input type="checkbox"/> </div> <div>           Water Jet <input type="checkbox"/>            Prod. Eng. Coord. <input type="checkbox"/>            Rec/Store/Packaging <input type="checkbox"/>            Supplier <input type="checkbox"/> </div> <div>           Engineering <input type="checkbox"/>            Quality <input type="checkbox"/>            Other <input type="checkbox"/> </div> </div>					
Root Cause	Date	Step	Qty	Description of work order update or Non-conformance	Initial Chief Eng	Action Description	Sign & Date	Verification	QC Inspector		
Doc/Data <input type="checkbox"/>											
Equip/Tooling <input type="checkbox"/>											
Operator <input type="checkbox"/>											
Material <input type="checkbox"/>											
Setup <input type="checkbox"/>											
Other <input type="checkbox"/>											
Process <input type="checkbox"/>											
Supplier <input type="checkbox"/>											
Training <input type="checkbox"/>											
Unapproved <input type="checkbox"/>											

FAULT CATEGORY				
<b>Landing Gear</b> <input type="checkbox"/> Bending <input type="checkbox"/> Centre Not Concentric to O/S <input type="checkbox"/> Cracks <input type="checkbox"/> Crushed/Crimped <input type="checkbox"/> Cuffs <input type="checkbox"/> Heat Treat <input type="checkbox"/> Inspection Strip in Tube <input type="checkbox"/> Ripples in Bend <input type="checkbox"/> Torque Waves in Extrusion <input type="checkbox"/> Turning Sequence <input type="checkbox"/> Wave/Twist in Tube	<b>General</b> <input type="checkbox"/> Bend <input type="checkbox"/> BOM/Route <input type="checkbox"/> Broken/Damaged <input type="checkbox"/> Burrs <input type="checkbox"/> Contamination <input type="checkbox"/> Countersink <input type="checkbox"/> Cut Too Short <input type="checkbox"/> Drill Holes <input type="checkbox"/> Drawing <input type="checkbox"/> Finish <input type="checkbox"/> Folio	<input type="checkbox"/> Grain <input type="checkbox"/> Hardware <input type="checkbox"/> Inspection Incomplete <input type="checkbox"/> Instructions Incomplete/Unclear <input type="checkbox"/> Maintenance <input type="checkbox"/> Mislabeled <input type="checkbox"/> Misread <input type="checkbox"/> Offset <input type="checkbox"/> Out of Calibration <input type="checkbox"/> Out of Sequence <input type="checkbox"/> Outside Dimensions	<input type="checkbox"/> Ovalized <input type="checkbox"/> Over/Under tolerance <input type="checkbox"/> Part Incorrect <input type="checkbox"/> Part Lost/Missing <input type="checkbox"/> Part Moved <input type="checkbox"/> Positioned Wrong <input type="checkbox"/> Power Loss/Surge  <input type="checkbox"/> Pressure/Forced <input type="checkbox"/> Temperature/Cure <input type="checkbox"/> Weld <input type="checkbox"/> Wrong Stock Pulled  <input type="checkbox"/> Other	

# Picklist Print

October-19-12 2:34:29 PM

Page 2

Work Order ID: 91933

Parent Item: D350-689-023

Parent Item Name: Energy Attenuating Floor Provisions

Start Date: 10/22/12

Required Date: 11/09/12

Start Qty: 1.00

Required Qty: 1.00

MS21042L3

Purchased No

110 Each 3,340.0000 9

9

Nut

## Location

## Loc Qty

## Loc Code

316	651	
122452	651	
ST300	338	
117885	32	
119017	168	
119075	138	
ST314	1831	
123265	1831	
ST317	520	
122141	520	

123265

MS24694-S50

Purchased No

110 Each 150.0000 9

9

Screw

## Location

## Loc Qty

## Loc Code

ST289	13	
116900	1	
118078	1	
119124	11	
ST289A	1	
121166	1	
ST303	100	
123352	100	
ST305	36	
122441	36	

2x 123352

7x 122441

October-19-12 2:34:29 PM

Shop Packet Print

Page 2

NCR: Yes / No

## WORK ORDER NON-CONFORMANCE / UPDATE

DQA: \_\_\_\_\_ Date: \_\_\_\_\_

QA Closed: \_\_\_\_\_ Date: \_\_\_\_\_

Work Order: _____  Part No. _____  NCR No. _____	<b>DISPOSITION</b>  Rework <input type="checkbox"/> Scrap <input type="checkbox"/> Use-as-is <input type="checkbox"/> Work Order Update <input type="checkbox"/>	<b>AGAINST DEPARTMENT/PROCESS</b>  <table style="width: 100%;"> <tr> <td>Skid-tube <input type="checkbox"/></td> <td>Crosstube <input type="checkbox"/></td> <td>Water Jet <input type="checkbox"/></td> <td>Engineering <input type="checkbox"/></td> </tr> <tr> <td>Machining <input type="checkbox"/></td> <td>Small Fab <input type="checkbox"/></td> <td>Prod. Eng. Coord. <input type="checkbox"/></td> <td>Quality <input type="checkbox"/></td> </tr> <tr> <td>Thermoforming <input type="checkbox"/></td> <td>Finishing <input type="checkbox"/></td> <td>Rec/Store/Packaging <input type="checkbox"/></td> <td>Other <input type="checkbox"/></td> </tr> <tr> <td>Large Fab <input type="checkbox"/></td> <td>Composite <input type="checkbox"/></td> <td>Supplier <input type="checkbox"/></td> <td></td> </tr> </table>	Skid-tube <input type="checkbox"/>	Crosstube <input type="checkbox"/>	Water Jet <input type="checkbox"/>	Engineering <input type="checkbox"/>	Machining <input type="checkbox"/>	Small Fab <input type="checkbox"/>	Prod. Eng. Coord. <input type="checkbox"/>	Quality <input type="checkbox"/>	Thermoforming <input type="checkbox"/>	Finishing <input type="checkbox"/>	Rec/Store/Packaging <input type="checkbox"/>	Other <input type="checkbox"/>	Large Fab <input type="checkbox"/>	Composite <input type="checkbox"/>	Supplier <input type="checkbox"/>	
Skid-tube <input type="checkbox"/>	Crosstube <input type="checkbox"/>	Water Jet <input type="checkbox"/>	Engineering <input type="checkbox"/>															
Machining <input type="checkbox"/>	Small Fab <input type="checkbox"/>	Prod. Eng. Coord. <input type="checkbox"/>	Quality <input type="checkbox"/>															
Thermoforming <input type="checkbox"/>	Finishing <input type="checkbox"/>	Rec/Store/Packaging <input type="checkbox"/>	Other <input type="checkbox"/>															
Large Fab <input type="checkbox"/>	Composite <input type="checkbox"/>	Supplier <input type="checkbox"/>																

Root Cause	Date	Step	Qty	Description of work order update or Non-conformance	Initial Chief Eng	Action Description	Sign & Date	Verification	QC Inspector
Doc/Data <input type="checkbox"/>									
Equip/Tooling <input type="checkbox"/>									
Operator <input type="checkbox"/>									
Material <input type="checkbox"/>									
Setup <input type="checkbox"/>									
Other <input type="checkbox"/>									
Process <input type="checkbox"/>									
Supplier <input type="checkbox"/>									
Training <input type="checkbox"/>									
Unapproved <input type="checkbox"/>									

### FAULT CATEGORY

<b>Landing Gear</b> <input type="checkbox"/> Bending <input type="checkbox"/> Centre Not Concentric to O/S <input type="checkbox"/> Cracks <input type="checkbox"/> Crushed/Crimped <input type="checkbox"/> Cuffs <input type="checkbox"/> Heat Treat <input type="checkbox"/> Inspection Strip in Tube <input type="checkbox"/> Ripples in Bend <input type="checkbox"/> Torque Waves in Extrusion <input type="checkbox"/> Turning Sequence <input type="checkbox"/> Wave/Twist in Tube	<b>General</b> <input type="checkbox"/> Bend <input type="checkbox"/> BOM/Route <input type="checkbox"/> Broken/Damaged <input type="checkbox"/> Burrs <input type="checkbox"/> Contamination <input type="checkbox"/> Countersink <input type="checkbox"/> Cut Too Short <input type="checkbox"/> Drill Holes <input type="checkbox"/> Drawing <input type="checkbox"/> Finish <input type="checkbox"/> Folio	<input type="checkbox"/> Grain <input type="checkbox"/> Hardware <input type="checkbox"/> Inspection Incomplete <input type="checkbox"/> Instructions Incomplete/Unclear <input type="checkbox"/> Maintenance <input type="checkbox"/> Mislabeled <input type="checkbox"/> Misread <input type="checkbox"/> Offset <input type="checkbox"/> Out of Calibration <input type="checkbox"/> Out of Sequence <input type="checkbox"/> Outside Dimensions  <input type="checkbox"/> Ovalized <input type="checkbox"/> Over/Under tolerance <input type="checkbox"/> Part Incorrect <input type="checkbox"/> Part Lost/Missing <input type="checkbox"/> Part Moved <input type="checkbox"/> Positioned Wrong <input type="checkbox"/> Power Loss/Surge  <input type="checkbox"/> Pressure/Forced <input type="checkbox"/> Temperature/Cure <input type="checkbox"/> Weld <input type="checkbox"/> Wrong Stock Pulled <input type="checkbox"/> Other _____ _____ _____ _____
---	---	---



# Picklist Print

October-19-12 2:34:29 PM

Page 3

Work Order ID: 91933

Parent Item: D350-689-023

Parent Item Name: Energy Attenuating Floor Provisions

Start Date: 10/22/12

Required Date: 11/09/12

Start Qty: 1.00

Required Qty: 1.00

NASH149D0363J

Washer

Purchased

No

110

Each

4,302.0000

9

9

23 12/10/24

Sm

## Location

## Loc Qty

## Loc Code

ST294

1308

123248

1308

123248

ST297

2883

122378

2883

ST298

111

117601

61

119537

33

120308

17

October-19-12 2:34:29 PM

Shop Packet Print

Page 3

NCR: Yes / No

## WORK ORDER NON-CONFORMANCE / UPDATE

DQA: \_\_\_\_\_ Date: \_\_\_\_\_

QA Closed: \_\_\_\_\_ Date: \_\_\_\_\_

Work Order: _____  Part No. _____  NCR No. _____	<b>DISPOSITION</b>  <div style="display: flex; justify-content: space-around;"> <div>             Rework <input type="checkbox"/>              Scrap <input type="checkbox"/>              Use-as-is <input type="checkbox"/>              Work Order Update <input type="checkbox"/> </div> <div>             Skid-tube <input type="checkbox"/>              Machining <input type="checkbox"/>              Thermoforming <input type="checkbox"/>              Large Fab <input type="checkbox"/> </div> <div>             Crosstube <input type="checkbox"/>              Small Fab <input type="checkbox"/>              Finishing <input type="checkbox"/>              Composite <input type="checkbox"/> </div> <div>             Water Jet <input type="checkbox"/>              Prod. Eng. Coord. <input type="checkbox"/>              Rec/Store/Packaging <input type="checkbox"/>              Supplier <input type="checkbox"/> </div> <div>             Engineering <input type="checkbox"/>              Quality <input type="checkbox"/>              Other <input type="checkbox"/> </div> </div>	<b>AGAINST DEPARTMENT/PROCESS</b>
--	--	-----------------------------------

Root Cause	Date	Step	Qty	Description of work order update or Non-conformance	Initial Chief Eng	Action Description	Sign & Date	Verification	QC Inspector
Doc/Data									
Equip/Tooling									
Operator									
Material									
Setup									
Other									
Process									
Supplier									
Training									
Unapproved									

### FAULT CATEGORY

<b>Landing Gear</b> <input type="checkbox"/> Bending <input type="checkbox"/> Centre Not Concentric to O/S <input type="checkbox"/> Cracks <input type="checkbox"/> Crushed/Crimped <input type="checkbox"/> Cuffs <input type="checkbox"/> Heat Treat <input type="checkbox"/> Inspection Strip in Tube <input type="checkbox"/> Ripples in Bend <input type="checkbox"/> Torque Waves in Extrusion <input type="checkbox"/> Turning Sequence <input type="checkbox"/> Wave/Twist in Tube	<b>General</b> <input type="checkbox"/> Bend <input type="checkbox"/> BOM/Route <input type="checkbox"/> Broken/Damaged <input type="checkbox"/> Burrs <input type="checkbox"/> Contamination <input type="checkbox"/> Countersink <input type="checkbox"/> Cut Too Short <input type="checkbox"/> Drill Holes <input type="checkbox"/> Drawing <input type="checkbox"/> Finish <input type="checkbox"/> Folio	<input type="checkbox"/> Grain <input type="checkbox"/> Hardware <input type="checkbox"/> Inspection Incomplete <input type="checkbox"/> Instructions Incomplete/Unclear <input type="checkbox"/> Maintenance <input type="checkbox"/> Mislabeled <input type="checkbox"/> Misread <input type="checkbox"/> Offset <input type="checkbox"/> Out of Calibration <input type="checkbox"/> Out of Sequence <input type="checkbox"/> Outside Dimensions	<input type="checkbox"/> Ovalized <input type="checkbox"/> Over/Under tolerance <input type="checkbox"/> Part Incorrect <input type="checkbox"/> Part Lost/Missing <input type="checkbox"/> Part Moved <input type="checkbox"/> Positioned Wrong <input type="checkbox"/> Power Loss/Surge	<input type="checkbox"/> Pressure/Forced <input type="checkbox"/> Temperature/Cure <input type="checkbox"/> Weld <input type="checkbox"/> Wrong Stock Pulled <input type="checkbox"/> Other
---	---	---	--	---

# DART SERVICE INSTRUCTION

TO AMEND INSTALLATION INSTRUCTIONS IIN-D350-689 REV. B  
AND INSTRUCTIONS FOR CONTINUED AIRWORTHINESS ICA-D350-689 REV. 1  
REF. TCCA STC: SH02-33  
REF. FAA STC: SR01620NY  
REF. EASA STC: EASA.IM.R.S.01453  
REF. TCA STC: 2005S03-09

## 1.0 PURPOSE

For D350-689-021/-023 Kits at CHG 005/004 and later, the D3026-1 Channel has been replaced with the D4575-1 Beam and D4575-3 Doubler and the D3234-3 Doubler has been removed. Consequently, the installation instructions for D350-689-021/-023 at CHG 005/004 are updated per Section 2.0 of this Service Instruction. The parts list update is shown in Section 4.0 of this Service Instruction. There is a negligible change to the weight and balance.

## 2.0 INSTALLATION CHANGES

Section 3.9, *INSTALLATION OF D350-689-023 ENERGY ATTENUATING FLOOR PROVISIONS KIT* (pages 8 and 9 of IIN-D350-689), is changed as follows:

### Item 3.9.8 is:

If there is an existing stringer at LBL 27.33, it will need to be removed from that location. Locate D4575-1 Beam and D4575-3 Doubler as shown in Figure 1 of this Service Instruction. Transfer drill existing holes from the aircraft floor to the D4575-1 Beam and D4575-3 Doubler. Ensure 1.0" to 1.5" rivet pitch and add additional holes if required. If there is no existing stringer, locate D4575-1 Beam and D4575-3 Doubler as shown in Figure 1 of this Service Instruction and drill Ø0.128" holes on a 1.0" to 1.5" pitch.

**Note:** Drill a Ø1.00" (Ø25.4 mm) hole in the D4575-1 Beam to clear extension tube of collective and cutout as required for clearance of collective opening and fwd bulkhead as shown in Figure 2 of this Service Instruction.

### Item 3.9.8 was:

If there is an existing stringer at LBL 27.33, it will need to be removed from that location. Locate D3026-1 Channel as shown in Figure 4 and transfer existing holes from the aircraft floor to the D3026-1 Channel. Ensure 1.0" to 1.5" rivet pitch and add additional holes if required. If there is no existing stringer, locate D3026-1 Channel as shown in Figure 4 and drill Ø0.128" holes on a 1.0" to 1.5" pitch.

### Item 3.9.10 is:

Attach D4575-1 Beam and D4575-3 Doubler to floor using qty (14) MS20426AD4 rivets.

### Item 3.9.10 was:

Attach D4575-1 Channel to floor using qty (14) MS20426AD4 rivets.

### Item 3.9.12 is no longer applicable:

Rivet D3234-3 Doubler to D3026-1 Channel as shown in Figure 7 using MS20470AD4 rivets.

### Item 3.9.12 was:

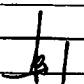


Rivet D3234-3 Doubler to D3026-1 Channel as shown in Figure 7 using MS20470AD4 rivets.

CANADA  
DEPARTMENT OF TRANSPORT  
AIRCRAFT CERTIFICATION  
BRANCH  
DAO # 01-O-01

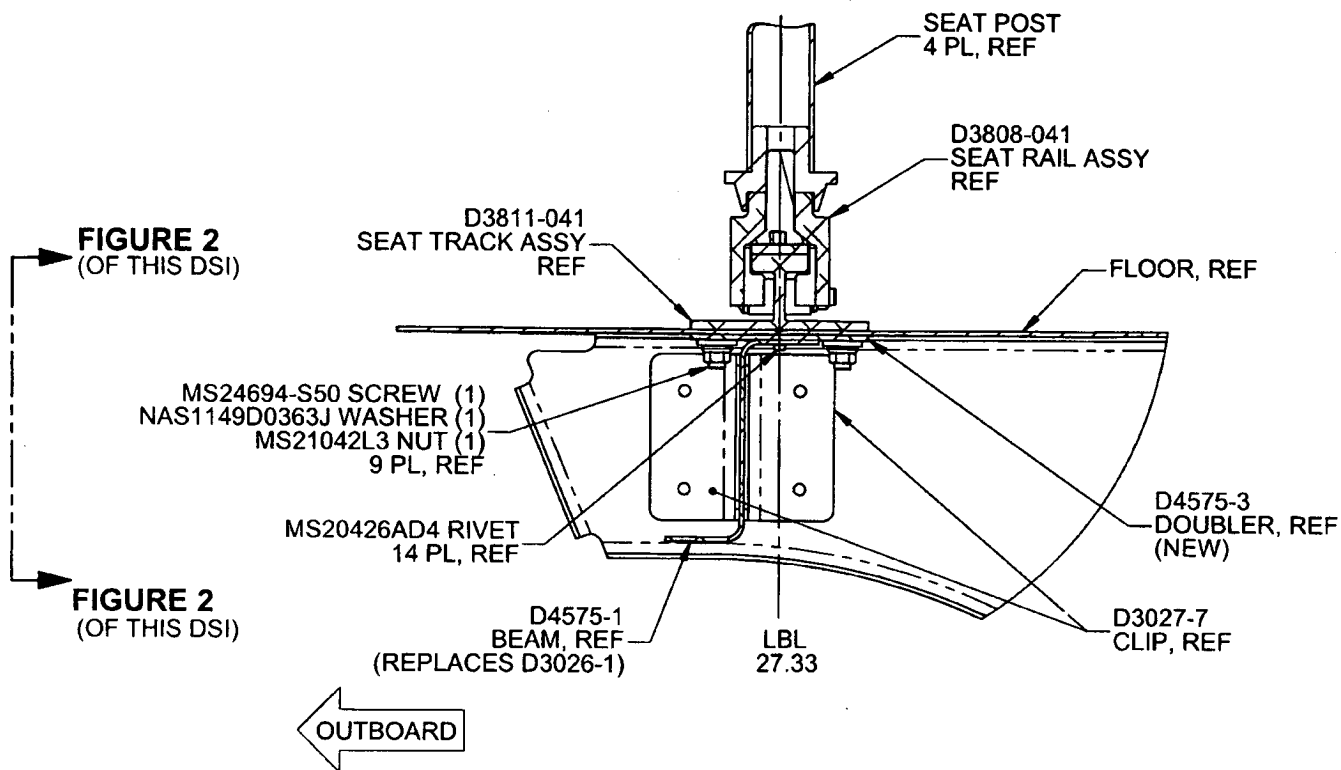
APPROVED

BY:   
D. SHEPHERD (DE # 02)

DATE: 11.12.23  
CERT. NO.: SH02-33  
ISSUE NO.: 1

A	NEW ISSUE	MB	11.12.22
REV.	DESCRIPTION	BY	DATE
DESIGN		DART AEROSPACE LTD	
DRAWN		HAWKESBURY, ONTARIO, CANADA	
CHECKED		DRAWING NO.	REV. A
MFG. APPR.	N/A	DSI 9588	SHEET 1 OF 4
APPROVED		TITLE	SCALE
DE APPR.		INSTALLATION CHANGE	NTS
DATE	11.12.22	COPYRIGHT © 2011 BY DART AEROSPACE LTD THIS DOCUMENT IS PRIVATE AND CONFIDENTIAL AND IS SUPPLIED ON THE EXPRESS CONDITION THAT IT IS NOT TO BE USED FOR ANY PURPOSE OR COPIED OR COMMUNICATED TO ANY OTHER PERSON WITHOUT WRITTEN PERMISSION FROM DART AEROSPACE LTD.	

12-10-22  
91933 MLS  
UNCONFINED  
REGION  
STRUT



**FIGURE 21: Cross Section View T-T from Figure 19 (IIN-D350-689)**  
**FIGURE 25-21: Cross Section View T-T from Figure 25-19 (ICA-D350-689)**

**FIGURE 1: UPDATES TO FIGURE 21 (IIN-D350-689) AND 25-21 (ICA-D350-689)**

With reference to Figures 19 and 20 of IIN-D350-689  
 (Figures 25-19 and 25-20 of ICA-D350-689)

CANADA  
 DEPARTMENT OF TRANSPORT  
 AIRCRAFT CERTIFICATION  
 BRANCH  
 DAO # 01-O-01

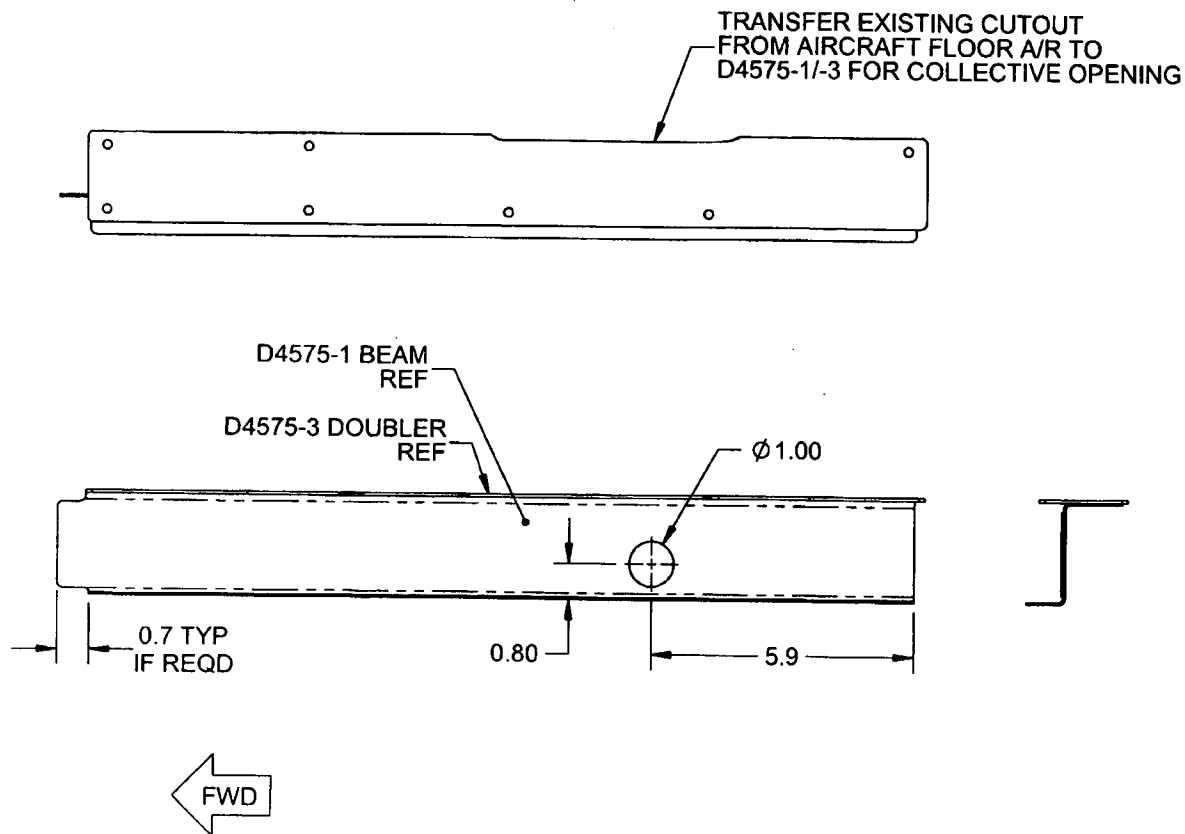
**APPROVED**

BY: [Signature]  
 D. SHEPHERD (DE # 02)

DATE: 11.12.23  
 CERT. NO.: SH02-33  
 ISSUE NO.: 1

DESIGN	<del>3</del>	<b>DART AEROSPACE LTD</b>	
DRAWN	<del>3</del>	HAWKESBURY, ONTARIO, CANADA	
CHECKED	<del>3</del>	DRAWING NO.	REV. A
MFG. APPR.	N/A	DSI 9588	SHEET 2 OF 4
APPROVED	<del>3</del>	TITLE	SCALE
DE APPR.	<del>3</del>	INSTALLATION CHANGE	NTS
DATE	11.12.22	COPYRIGHT © 2011 BY DART AEROSPACE LTD	
THIS DOCUMENT IS PRIVATE AND CONFIDENTIAL AND IS SUPPLIED ON THE EXPRESS CONDITION THAT IT IS NOT TO BE USED FOR ANY PURPOSE OR COPIED OR COMMUNICATED TO ANY OTHER PERSON WITHOUT WRITTEN PERMISSION FROM DART AEROSPACE LTD.			

01933



**FIGURE 2: RELIEFS ON D4575-1/-3**  
(ONLY D4575-1/-3 SHOWN FOR CLARITY)  
VIEW LOOKING INBOARD

CANADA  
DEPARTMENT OF TRANSPORT  
AIRCRAFT CERTIFICATION  
BRANCH  
DAO # 01-O-01

**APPROVED**  
BY: *[Signature]*  
D. SHEPHERD (DE # 02)

DATE: 11.12.23  
CERT. NO.: SH02-33  
ISSUE NO.: 1

DESIGN	<i>[Signature]</i>	<b>DART AEROSPACE LTD</b>	
DRAWN	<i>[Signature]</i>	HAWKESBURY, ONTARIO, CANADA	
CHECKED	<i>[Signature]</i>	DRAWING NO.	REV. A
MFG. APPR.	N/A	DSI 9588	SHEET 3 OF 4
APPROVED	<i>[Signature]</i>	TITLE	SCALE
DE APPR.	<i>[Signature]</i>	INSTALLATION CHANGE	NTS
DATE	11.12.22	COPYRIGHT © 2011 BY DART AEROSPACE LTD THIS DOCUMENT IS PRIVATE AND CONFIDENTIAL AND IS SUPPLIED ON THE EXPRESS CONDITION THAT IT IS NOT TO BE USED FOR ANY PURPOSE OR COPIED OR COMMUNICATED TO ANY OTHER PERSON WITHOUT WRITTEN PERMISSION FROM DART AEROSPACE LTD	

91933

#### 4.0 PARTS LIST CHANGE

The parts list of D350-689-021/-023 at CHG 005/004 or later is amended as follows:

##### 5. PARTS LIST (IIN-D350-689)

##### 25.10 PARTS LIST (ICA-D350-689)

IS:

Qty -011	Qty -013	Qty -015	Qty -017	Qty -019	Qty -021	Qty -023	Qty -041	Qty -043	Part Number	Description
X									D350-689-011	DUAL HIGH BACK SEAT INSTALLATION, LH
1	X								D350-689-013	FLOOR PROVISIONS KIT
		X							D350-689-015	SEAT MODIFICATION KIT
			X						D350-689-017	SHOULDER HARNESS KIT
				X					D350-689-019	CONTROL GUARD KIT
					X				D350-689-021	DUAL HIGH BACK SEAT INSTALLATION, LH
					1	X			D350-689-023	ENERGY ATTENUATING FLOOR PROVISIONS KIT
1							X		D350-689-041	DUAL HIGH BACK SEAT ASSEMBLY
					1			X	D350-689-043	DUAL HIGH BACK SEAT ASSEMBLY
	1								D3026-1	CHANNEL (REMOVED FROM -023)
	1								D3234-3	DOUBLER (REMOVED FROM -023)
						1			D4575-1	BEAM (REPLACES D3026-1 IN -023)
						1			D4575-3	DOUBLER (NEW IN -023)

WAS:



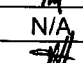

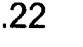
Qty -011	Qty -013	Qty -015	Qty -017	Qty -019	Qty -021	Qty -023	Qty -041	Qty -043	Part Number	Description
X									D350-689-011	DUAL HIGH BACK SEAT INSTALLATION, LH
1	X								D350-689-013	FLOOR PROVISIONS KIT
		X							D350-689-015	SEAT MODIFICATION KIT
			X						D350-689-017	SHOULDER HARNESS KIT
				X					D350-689-019	CONTROL GUARD KIT
					X				D350-689-021	DUAL HIGH BACK SEAT INSTALLATION, LH
					1	X			D350-689-023	ENERGY ATTENUATING FLOOR PROVISIONS KIT
1							X		D350-689-041	DUAL HIGH BACK SEAT ASSEMBLY
					1			X	D350-689-043	DUAL HIGH BACK SEAT ASSEMBLY
	1					1			D3026-1	CHANNEL
	1					1			D3234-3	DOUBLER

CANADA  
DEPARTMENT OF TRANSPORT  
AIRCRAFT CERTIFICATION  
BRANCH  
DAO # 01-O-01

APPROVED

BY:   
D. SHEPHERD (DE # 02)

DATE: 11.12.23  
CERT. NO.: SH02-33  
ISSUE NO.: 1

DESIGN		<b>DART AEROSPACE LTD</b>	
DRAWN		HAWKESBURY, ONTARIO, CANADA	
CHECKED		DRAWING NO. <b>DSI 9588</b>	REV. A
MFG. APPR.	N/A	SHEET 4 OF 4	
APPROVED		TITLE <b>INSTALLATION CHANGE</b>	SCALE NTS
DE APPR.		COPYRIGHT © 2011 BY DART AEROSPACE LTD	
DATE <b>11.12.22</b>		THIS DOCUMENT IS PRIVATE AND CONFIDENTIAL AND IS SUPPLIED ON THE EXPRESS CONDITION THAT IT IS NOT TO BE USED FOR ANY PURPOSE OR COPIED OR COMMUNICATED TO ANY OTHER PERSON WITHOUT WRITTEN PERMISSION FROM DART AEROSPACE LTD.	

91933

Qty -011	Qty -013	Qty -015	Qty -017	Qty -019	Qty -021	Qty -023	Qty -041	Qty -043	Part Number	Description
	1					1			D3026-1	CHANNEL
	1								D3027-1	CLIP
	1								D3027-3	CLIP
	1								D3027-5	CLIP
	4					<del>4</del>			<del>D3027-7</del>	<del>CLIP</del>
							4		D3028-1	STUD
		2					2		D3029-1	SPRING
		2					2		D3030-1	LOCK
							2	2	D3031-1	LOOP
	1								D3032-1	SPACER
	2	1							D3033-1	SEAT TRACK
		4							D3059-1	STUD
		4							D3060-1	BUSHING
		4							D3061-1	RADIUS BLOCK
				1					D3084-3	STRUT
	1								D3234-1	DOUBLER
	1					1			D3234-3	DOUBLER
	2								D3234-5	SPACER
								2	D3808-041	SEAT RAIL ASSEMBLY
								4	D3809-1	SLIDING BLOCK
						<del>1</del>			<del>D3811-041</del>	<del>SEAT TRACK ASSEMBLY</del>
			2						D4071-041	SHOULDER HARDNESS ASSY
							3	3	AN3-12A	BOLT
				1					AN4-12A	BOLT
				1					AN4-20A	BOLT
			2						AN5-4A	BOLT
							40	40	MS20600AD4W2	RIVET
							6	6	MS20600AD4W3	RIVET
						<del>17</del>	<del>17</del>	<del>17</del>	<del>MS21042L3</del>	<del>NUT (OR MS21042-3)</del>
				2			6	6	MS21042L4	NUT (OR MS21042-4)
		4	2						MS21042L5	NUT (OR MS21042-5)
12	4								MS21059L3	NUTPLATE
							4	4	MS24693-S272	SCREW
2	1								MS24693-S273	SCREW
								8	MS24694-S3	SCREW
						<del>9</del>			<del>MS24694-S50</del>	<del>SCREW</del>
							4		MS24694-S148	SCREW
6	3								MS27039-1-10	SCREW
							4	4	MS27039-1-17	SCREW
							6	6	MS27039-1-19	SCREW
							6	6	MS27039-4-21	SCREW
6	3						17	17	NAS1149D0332J	WASHER (OR AN960JD10L)
						<del>9</del>			<del>NAS1149D0363J</del>	<del>WASHER (OR AN960JD10)</del>
				8					NAS1149D0416J	WASHER (OR AN960JD416L)
							6	6	NAS1149D0432J	WASHER (OR AN960JD416)
			4						NAS1149D0516J	WASHER (OR AN960JD516L)
		4							NAS1149D0563J	WASHER (OR AN960JD516)
				2					NAS43DD4-46N	SPACER

REFERENCE ONLY

Sms

#### 4.0 PARTS LIST CHANGE

The parts list of D350-689-021/-023 at CHG 005/004 or later is amended as follows:

5. PARTS LIST (IIN-D350-689)  
25.10 PARTS LIST (ICA-D350-689)

IS:

Qty -011	Qty -013	Qty -015	Qty -017	Qty -019	Qty -021	Qty -023	Qty -041	Qty -043	Part Number	Description
X									D350-689-011	DUAL HIGH BACK SEAT INSTALLATION, LH
1	X								D350-689-013	FLOOR PROVISIONS KIT
		X							D350-689-015	SEAT MODIFICATION KIT
			X						D350-689-017	SHOULDER HARNESS KIT
				X					D350-689-019	CONTROL GUARD KIT
					X				D350-689-021	DUAL HIGH BACK SEAT INSTALLATION, LH
					1	X			D350-689-023	ENERGY ATTENUATING FLOOR PROVISIONS KIT
1							X		D350-689-041	DUAL HIGH BACK SEAT ASSEMBLY
					1			X	D350-689-043	DUAL HIGH BACK SEAT ASSEMBLY
	1								D3026-1	CHANNEL (REMOVED FROM -023)
	1								D3234-3	DOUBLER (REMOVED FROM -023)
									<del>D4575-1</del>	<del>BEAM (REPLACES D3026-1 IN -023)</del>
									<del>D4575-3</del>	<del>DOUBLER (NEW IN -023)</del>

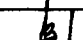

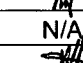

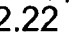
WAS:

Qty -011	Qty -013	Qty -015	Qty -017	Qty -019	Qty -021	Qty -023	Qty -041	Qty -043	Part Number	Description
X									D350-689-011	DUAL HIGH BACK SEAT INSTALLATION, LH
1	X								D350-689-013	FLOOR PROVISIONS KIT
		X							D350-689-015	SEAT MODIFICATION KIT
			X						D350-689-017	SHOULDER HARNESS KIT
				X					D350-689-019	CONTROL GUARD KIT
					X				D350-689-021	DUAL HIGH BACK SEAT INSTALLATION, LH
					1	X			D350-689-023	ENERGY ATTENUATING FLOOR PROVISIONS KIT
1							X		D350-689-041	DUAL HIGH BACK SEAT ASSEMBLY
					1			X	D350-689-043	DUAL HIGH BACK SEAT ASSEMBLY
	1					1			D3026-1	CHANNEL
	1					1			D3234-3	DOUBLER

CANADA  
DEPARTMENT OF TRANSPORT  
AIRCRAFT CERTIFICATION  
BRANCH  
DAO # 01-O-01

APPROVED  
BY:   
D. SHEPHERD (DE # 02)

DATE: 11.12.23  
CERT. NO.: SH02-33  
ISSUE NO.: 1

DESIGN		<b>DART AEROSPACE LTD</b> HAWKESBURY, ONTARIO, CANADA
DRAWN		
CHECKED		DRAWING NO. REV. A
MFG. APPR.	N/A	DSI 9588 SHEET 4 OF 4
APPROVED		TITLE SCALE
DE APPR.		INSTALLATION CHANGE NTS
DATE	11.12.22	COPYRIGHT © 2011 BY DART AEROSPACE LTD THIS DOCUMENT IS PRIVATE AND CONFIDENTIAL AND IS SUPPLIED ON THE EXPRESS CONDITION THAT IT IS NOT TO BE USED FOR ANY PURPOSE OR COPIED OR COMMUNICATED TO ANY OTHER PERSON WITHOUT WRITTEN PERMISSION FROM DART AEROSPACE LTD.



**4. WEIGHT AND BALANCE**

The following weight and balance information is for the Dart Dual High Back Seat Installation. The weight and balance of the parts that are removed from the aircraft to perform this installation are the responsibility of the installer.

Installation	Weight	LATERAL		LONGITUDINAL	
		Arm	Moment	Arm	Moment
D350-689-011 Dual High Back Seat Installation, Fwd Position	27.6 lb 12.5 kg	-18.2 in -0.46 m	-502 in-lb -5.8 m-k-g	60.7 in 1.54 m	1675 in-lb 19.3 m-k-g
D350-689-013 Floor Provisions Kit, Fwd Position	2.0 lb 0.9 kg	-18.2 in -0.46 m	-36 in-lb -0.4 m-k-g	60.7 in 1.54 m	121 in-lb 1.4 m-k-g
D350-689-011 Dual High Back Seat Installation, Aft Position	28.1 lb 12.7 kg	-18.2 in -0.46 m	-511 in-lb -5.8 m-k-g	63.7 in 1.62 m	1790 in-lb 20.57 m-k-g
D350-689-013 Floor Provisions Kit, Aft Position	3.1 lb 1.4 kg	-18.2 in -0.46 m	-56 in-lb -0.6 m-k-g	62.2 in 1.58 m	193 in-lb 2.2 m-k-g
D350-689-015 Seat Modification Kit	1.0 lb 0.5 kg	-17.2 in -0.44 m	-17 in-lb -0.22 m-k-g	60.7 1.54 m	61 in-lb 0.77 m-k-g
D350-689-017 Shoulder Harness, Fwd Position	4.4 lb 2.00 kg	-18.2 in -0.46 m	-80.1 in-lb -0.92 m-k-g	60.7 in 1.54 m	267 in-lb 3.08 m-k-g
D350-689-017 Shoulder Harness, Aft Position	4.4 lb 2.00 kg	-18.2 in -0.46 m	-80.1 in-lb -0.92 m-k-g	64.7 in 1.64 m	285 in-lb 3.28 m-k-g
D350-689-019 Control Guard, Fwd Position	0.5 lb 0.23 kg	-9.0 in -0.23 m	-4.5 in-lb -0.05 m-k-g	60.7 in 1.54 m	30 in-lb 0.35 m-k-g
D350-689-019 Control Guard, Aft Position	0.5 lb 0.23 kg	-9.0 in -0.23 m	-4.5 in-lb -0.05 m-k-g	64.7 in 1.64 m	32 in-lb 0.38 m-k-g
D350-689-021 Dual High Seat Back Installation, LH Fwd Position	29.2 lb 13.2 kg	-18.2 in -0.46 m	-531 in-lb -6.1 m-k-g	60.7 in 1.54 m	1772 in-lb 20.3 m-k-g
D350-689-021 Dual High Seat Back Installation, LH Aft Position	29.2 lb 13.2 kg	-18.2 in -0.46 m	-531 in-lb -6.1 m-k-g	64.7 in 1.64 m	1889 in-lb 21.6 m-k-g
D350-689-023 Energy Attenuating Floor Provisions Kit	2.5 lb 1.1 kg	-18.2 in -0.46 m	-46 in-lb -0.5 m-k-g	62.2 in 1.58 m	156 in-lb 1.7 m-k-g

**5. PARTS LIST**

Qty -011	Qty -013	Qty -015	Qty -017	Qty -019	Qty -021	Qty -023	Qty -041	Qty -043	Part Number	Description
X									D350-689-011	DUAL HIGH BACK SEAT INSTALLATION, LH
1	X								D350-689-013	FLOOR PROVISIONS KIT
		X							D350-689-015	SEAT MODIFICATION KIT
			X						D350-689-017	SHOULDER HARNESS KIT
				X					D350-689-019	CONTROL GUARD KIT
					X				D350-689-021	DUAL HIGH BACK SEAT INSTALLATION, LH
					1	X			D350-689-023	ENERGY ATTENUATING FLOOR PROVISIONS KIT
1							X		D350-689-041	DUAL HIGH BACK SEAT ASSEMBLY
					1			X	D350-689-043	DUAL HIGH BACK SEAT ASSEMBLY
							2	2	D3016-041	SEAT FRAME ASSEMBLY
							1	1	D3017-041	BACK FRAME ASSEMBLY
1					1				D3018-1	SEAT CUSHION
1					1				D3019-1	BACK CUSHION
							1	1	D3021-041	TUBE ASSEMBLY
							1	1	D3022-1	SEAT PAN
							1	1	D3023-1	BACK PANEL
							3	3	D3024-1	SPACER
	1								D3025-1	BEAM

• COPYRIGHT © 2011 BY DART AEROSPACE LTD. •  
THIS DOCUMENT IS PRIVATE AND CONFIDENTIAL AND IS SUPPLIED ON THE EXPRESS CONDITION THAT IT IS NOT TO BE USED FOR ANY PURPOSE OR COPIED OR COMMUNICATED TO ANY OTHER PERSON WITHOUT WRITTEN PERMISSION FROM DART AEROSPACE LTD.

Revision: **B**

Date: 11.07.22